




NOTE:
- CONTOURS REPRESENT EXISTING GROUND ELEVATIONS.

As-Built Drawing
Drawing compiled from visual observations of various parts of construction and/or from information by others. Accuracy not warranted. Independent verification required before application.

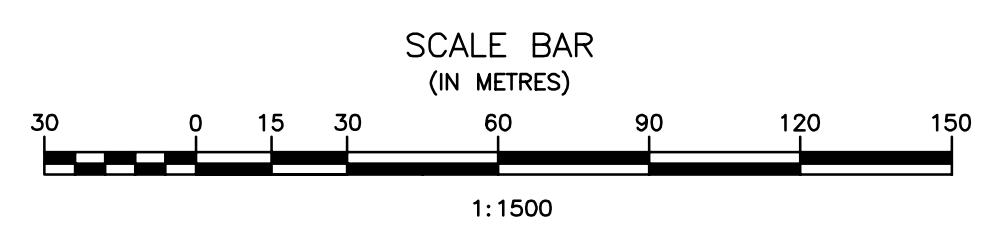

No.	REVISIONS	DATE	INITIALS
2	AS BUILT DRAWING	2018/03	RH
1	ISSUED FOR TENDER	2016/08	OT

B.M. EL.
REFER TO PLAN G12 FOR BENCHMARK LOCATION

LOCATIONS OF UNDERGROUND STRUCTURES/UTILITIES AS SHOWN ARE BASED ON AVAILABLE INFORMATION BUT NO GUARANTEE IS GIVEN OR IMPLIED THAT ALL EXISTING UNDERGROUND STRUCTURES/UTILITIES ARE SHOWN OR THAT THE GIVEN LOCATIONS ARE EXACT. CONFIRMATION OF EXISTENCE AND EXACT LOCATION OF ALL UNDERGROUND STRUCTURES/UTILITIES MUST BE OBTAINED FROM THE APPROPRIATE AUTHORITY/OWNER, BY THE CONTRACTOR, BEFORE PROCEEDING WITH CONSTRUCTION.

APEGM
Certificate of Authorization
J.R. Cousin Consultants Ltd.
No. 234 Date: 16/08/18

ENGINEER'S SEAL
ORIGINAL DRAWING
SIGNED AND SEALED
BY
B.J.D. MCCORMAC
16/08/18

JRC **ENGINEERING CONSULTANTS**
ENGINEERING EXCELLENCE SINCE 1981

JR Cousin Consultants Ltd.
91A Scurfield Blvd. Winnipeg MB R3Y 1G4
p. (204) 489-0474
f. (204) 489-0487
www.jrcc.ca

CODE: L-169.75	PROJECT: RM OF LA BROQUERIE WASTEWATER TREATMENT LAGOON EXPANSION
DESIGNED BY: BM	TITLE: EXISTING LAGOON LAYOUT, TEST HOLE LOCATIONS AND CONTOUR LINE PLAN
DRAWN BY: OT	SCALE: 1:1500
REVIEWED BY: JC	DATE: 15/05/26
	PLAN: L1
	SHEET: 3 of 34

Mar 20, 2018 - JRC - Design File: 171031016 - La Broquerie WWT - Design File: 171031016 - Design File: 171031016 - Design File: 171031016 - Design File: 171031016